

REPUBLIC OF THE PHILIPPINES  
DEPARTMENT OF PUBLIC WORKS & HIGHWAYS  
OFFICE OF THE BUILDING OFFICIAL

CEBU CITY


RECOMMENDING APPROVAL:

HEAD, ARCHITECTURAL SECTIONDATE:

APPROVED:

BUILDING OFFICIALDATE:


- base station
- sensor nodes
- relay nodes

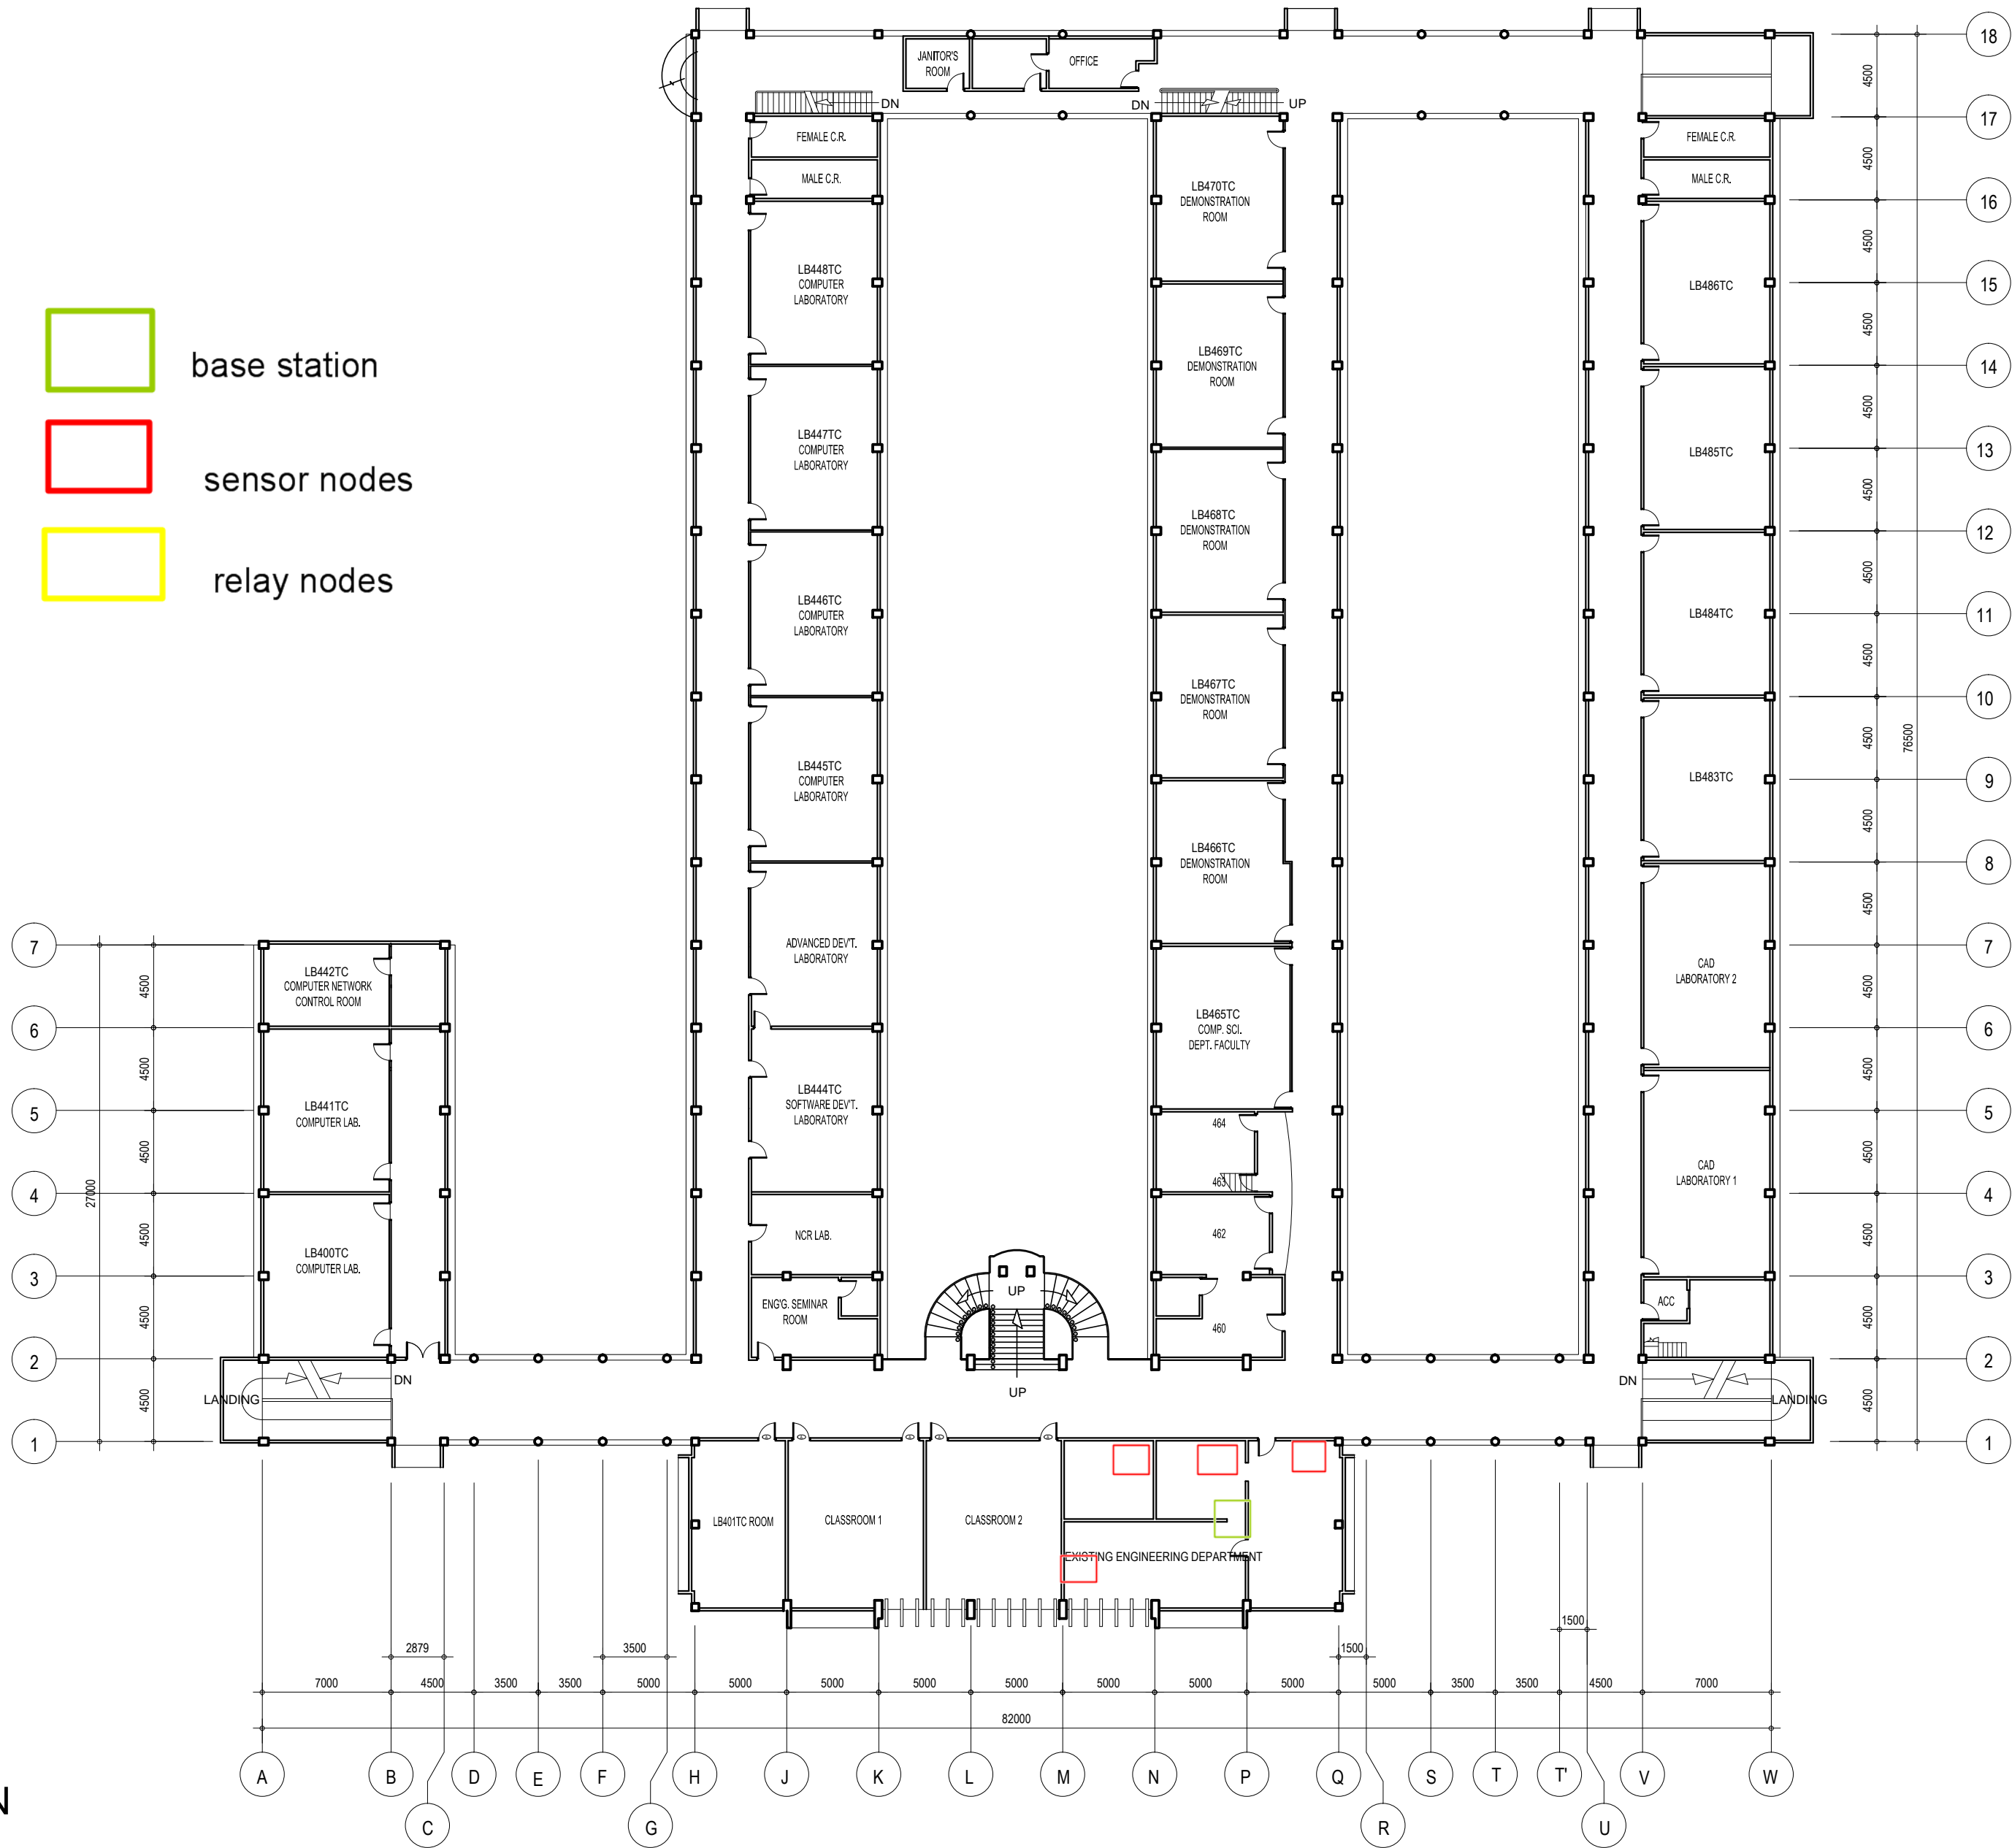

01  
- 07

FOURTH FLOOR PLAN

SCALE 1: 300 M

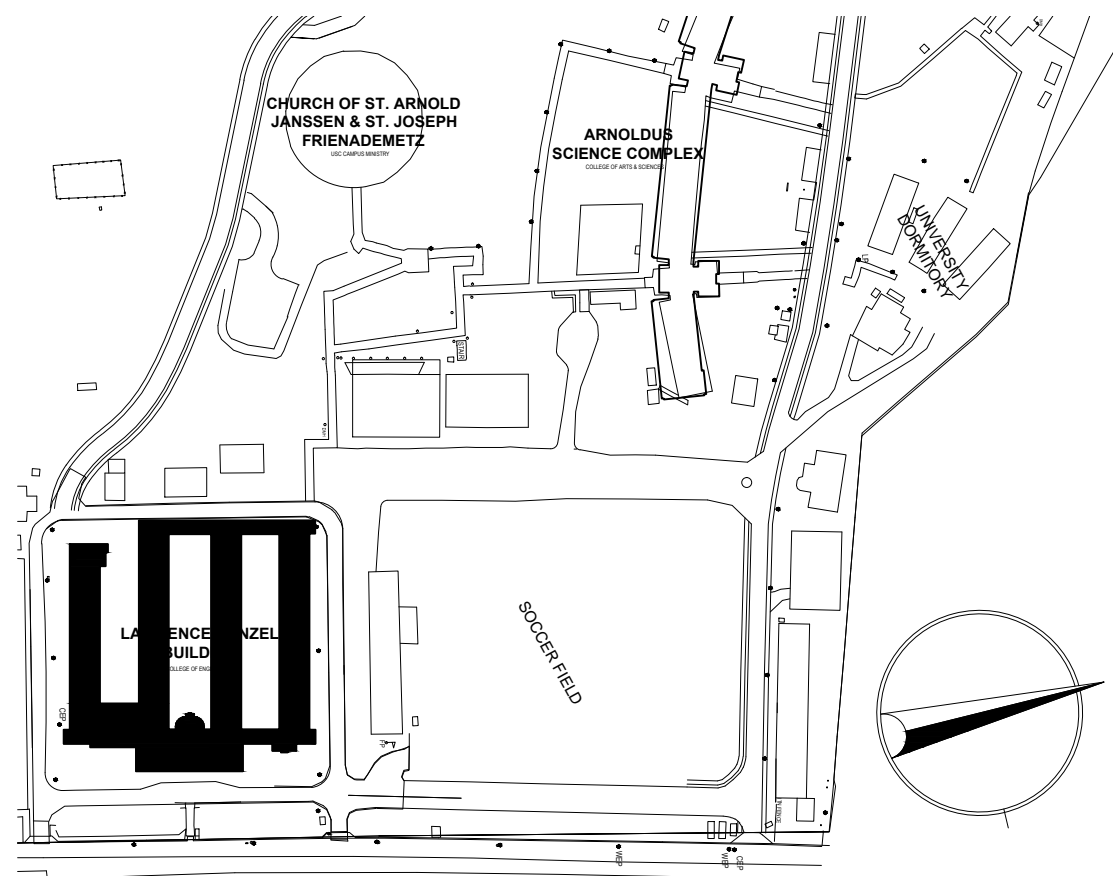

02  
- 07

KEY PLAN

NTS



ELLIS A. PUERTO  
ARCHITECT

PRC NO. :	VALIDITY :
IAPOA NO. :	O.R. NO. : DATE:
PTR NO. :	DATE :
PLACE :	TIN :

**R.A. 9266 ARTICLE IV SEC. 33**  
DRAWINGS AND SPECIFICATIONS AND OTHER CONTRACT DOCUMENTS DULY SIGNED, STAMPED OR SEALED, AS INSTRUMENTS OF SERVICE, ARE THE INTELLECTUAL PROPERTY AND DOCUMENTS OF THE ARCHITECT, WHETHER THE OBJECT FOR WHICH THEY ARE MADE IS EXECUTED OR NOT. IT SHALL BE UNLAWFUL FOR ANY PERSON TO DUPLICATE OR TO MAKE COPIES OF SAID DOCUMENTS FOR USE IN THE REPETITION OF AND FOR OTHER PROJECTS OR BUILDINGS, WHETHER EXECUTED PARTLY OR IN WHOLE, WITHOUT THE WRITTEN CONSENT OF ARCHITECT OR AUTHOR OF SAID DOCUMENTS.

PROJECT  
TITLE:

AS-BUILT PLAN OF  
LAWRENCE BUNZEL BUILDING

OWNER:

UNIVERSITY OF SAN CARLOS

LOCATION:

TALAMBAN, CEBU CITY, PHILIPPINES

SHEET CONTENTS

FOURTH FLOOR PLAN

ENCODED BY: MARK V. MEDRANO  
REVISED BY:

REVISIONS

- 1
- 2
- 3

APPROVED:

FR. DIONISIO M. MIRANDA, SVD  
PRESIDENT

ADDRESS:

CONTRACT DRAWING NO.

A-006  
A-000

DATE: