



REPUBLIC OF THE PHILIPPINES DEPARTMENT OF PUBLIC WORKS & HIGHWAYS OFFICE OF THE BUILDING OFFICIAL	
CEBU CITY	
RECOMMENDING APPROVAL:	
HEAD, ARCHITECTURAL SECTION	DATE:
APPROVED:	
BUILDING OFFICIAL	DATE:

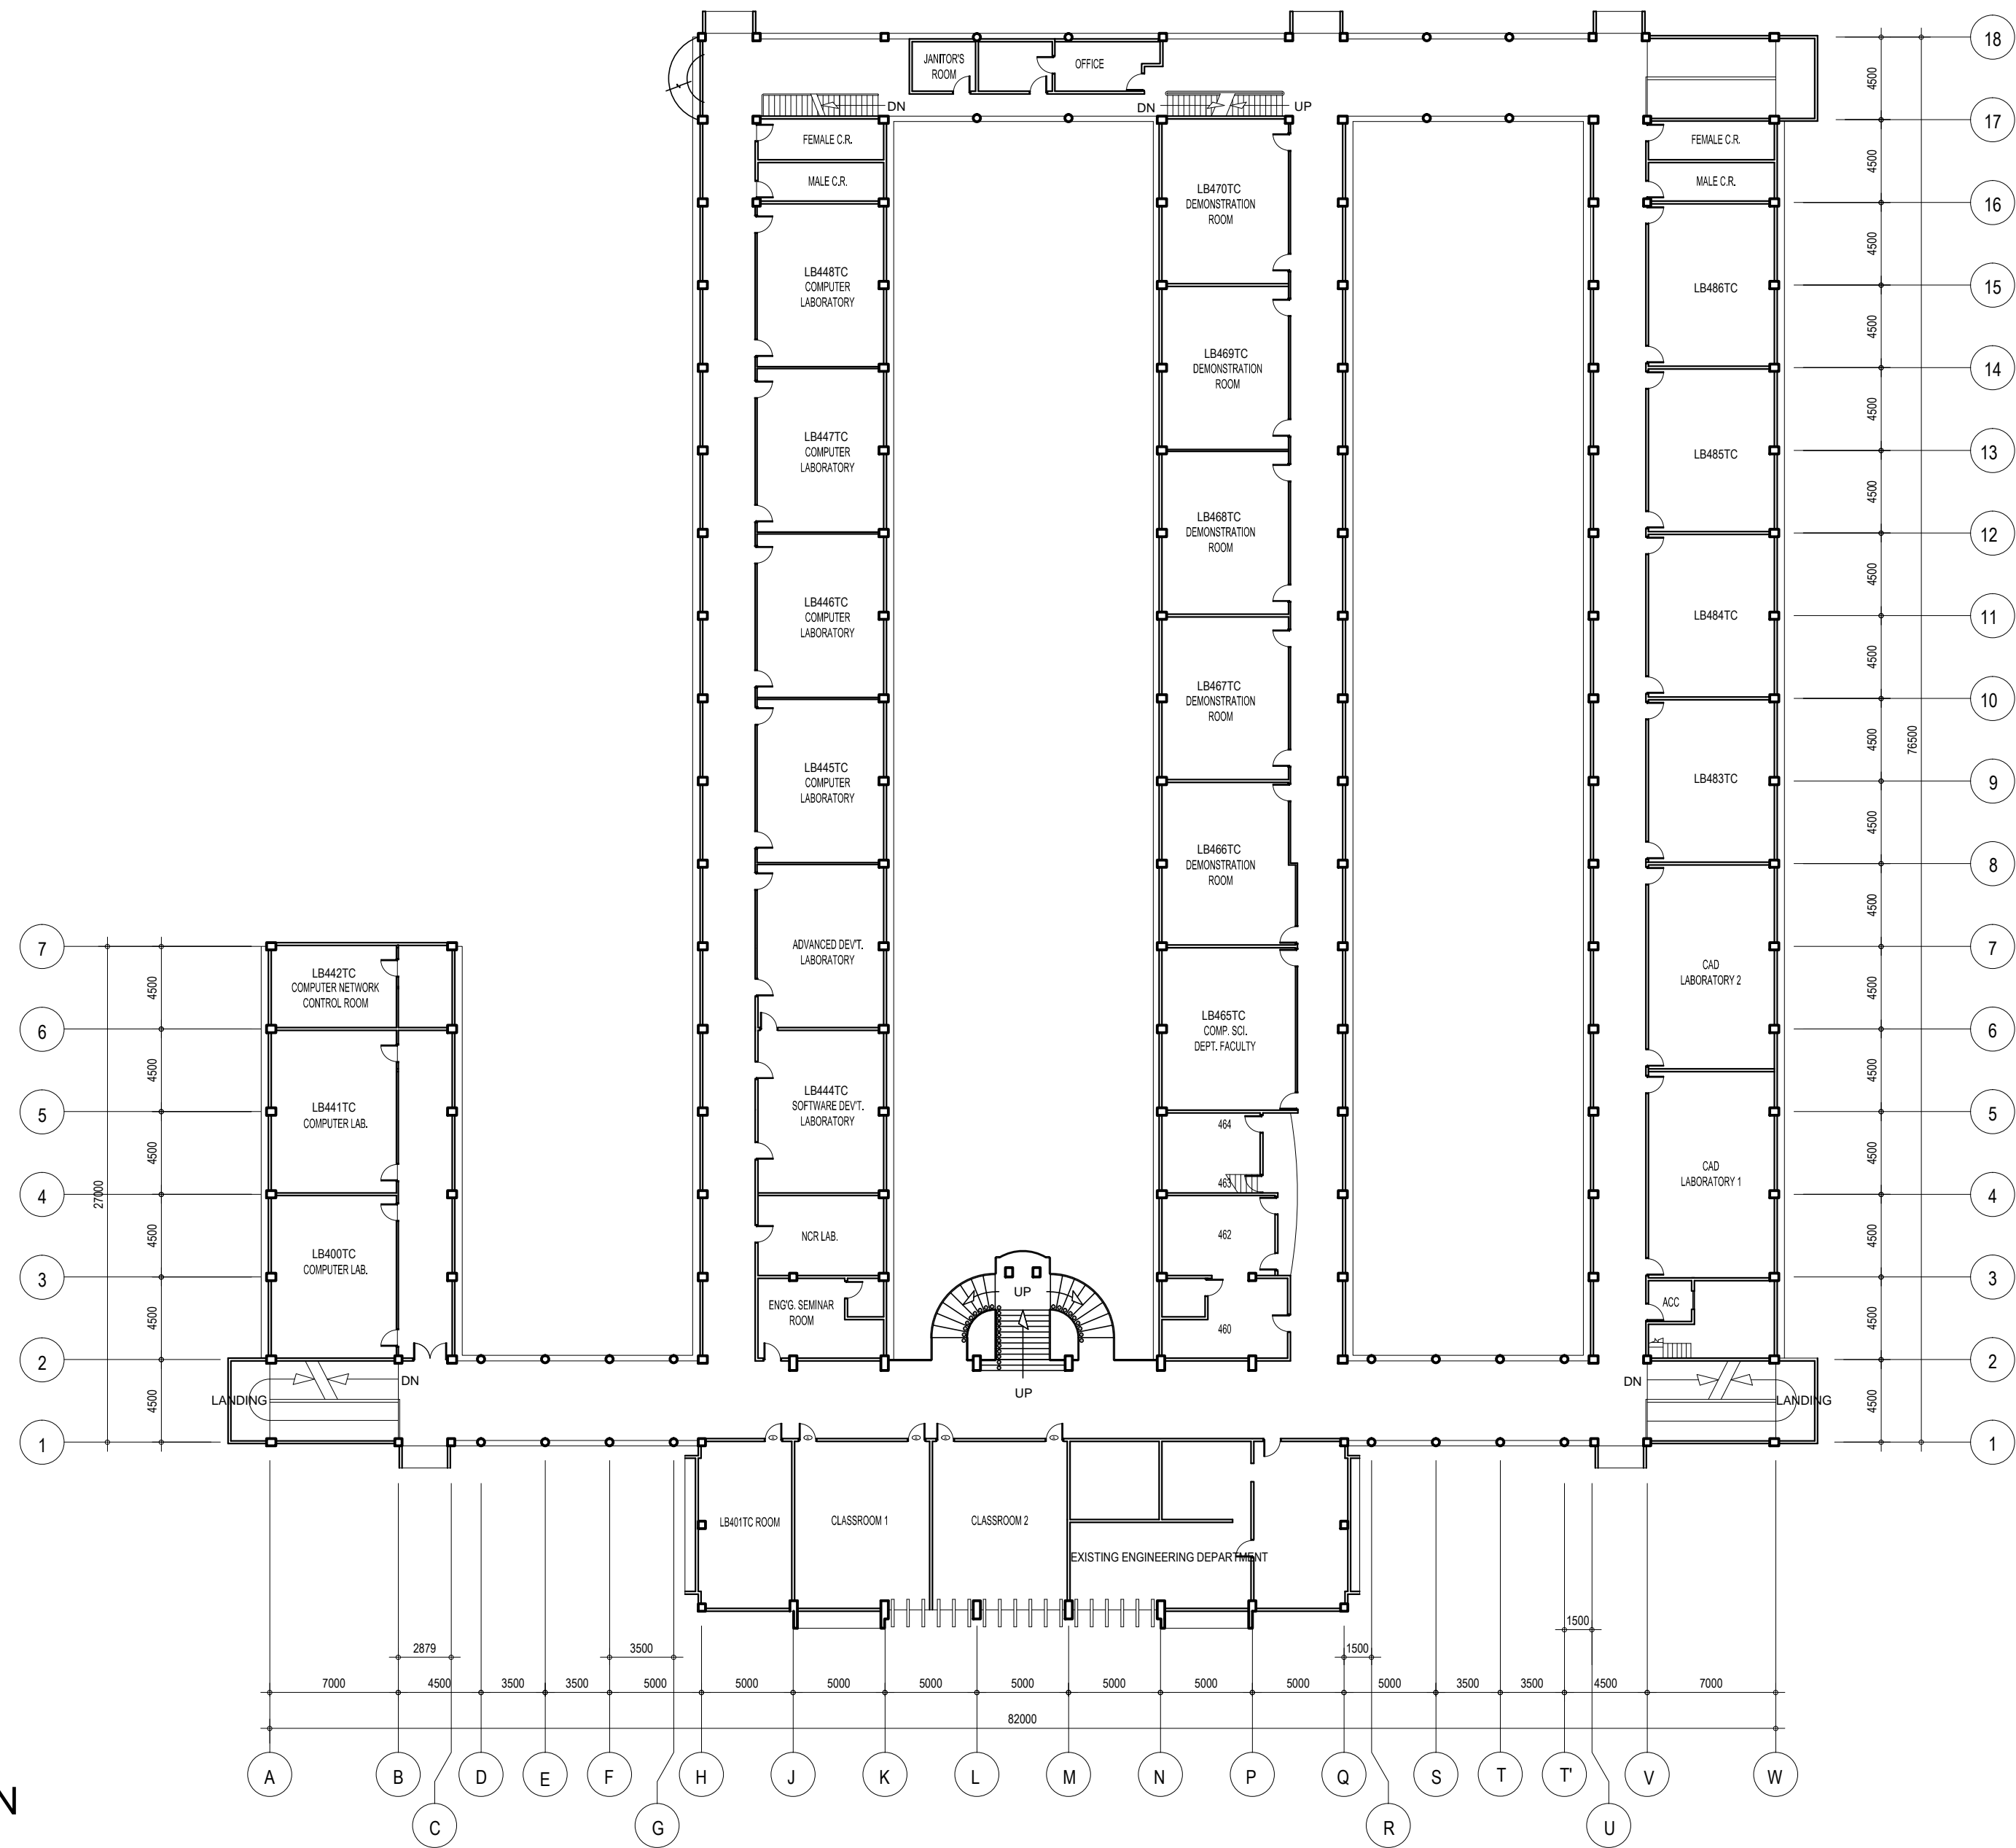

01  
- 07  
**FOURTH FLOOR PLAN**  
SCALE 1: 300 M

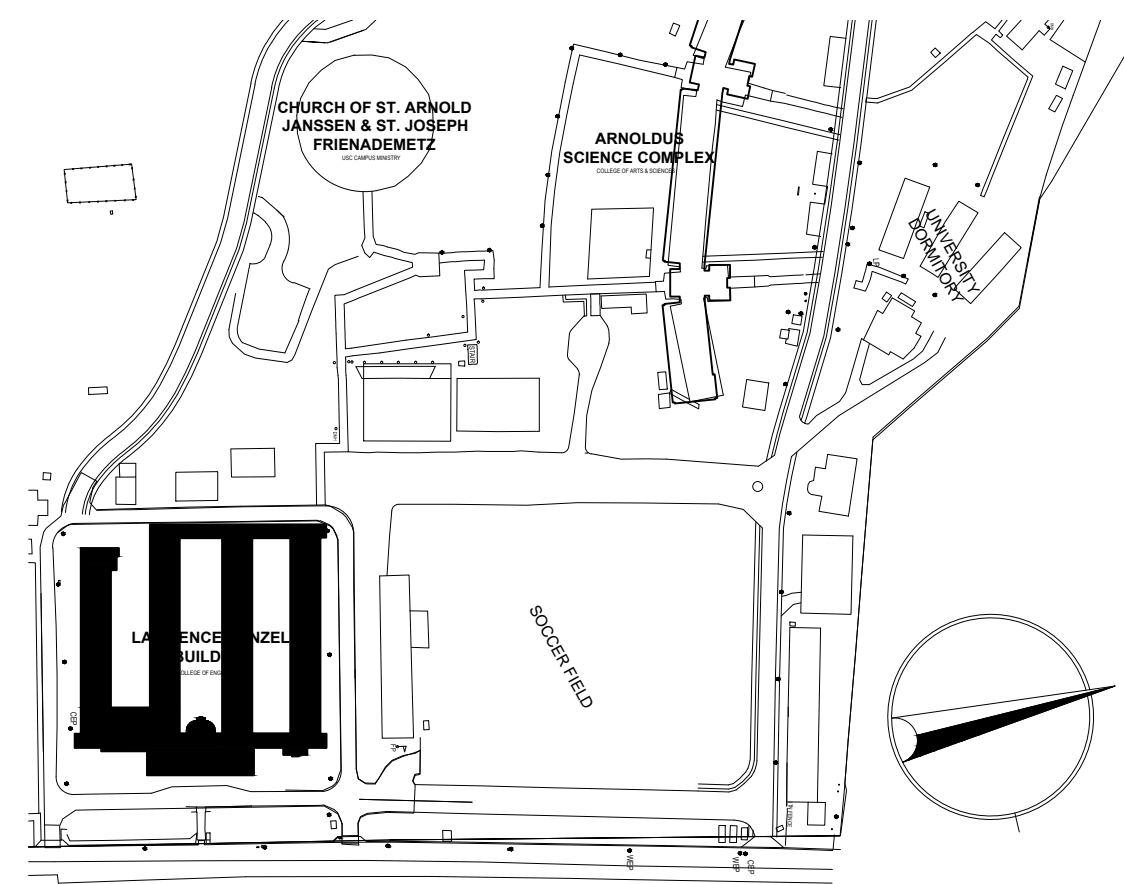

02  
- 07  
**KEY PLAN**  
NTS



**ELLIS A. PUERTO**  
ARCHITECT

PRC NO. :	VALIDITY :
IAPOA NO. :	O.R. NO. : DATE:
PTR NO. :	DATE :
PLACE :	TIN :

**R.A. 9266 ARTICLE IV SEC. 33**  
DRAWINGS AND SPECIFICATIONS AND OTHER CONTRACT DOCUMENTS DULY SIGNED, STAMPED OR SEALED, AS INSTRUMENTS OF SERVICE, ARE THE INTELLECTUAL PROPERTY AND DOCUMENTS OF THE ARCHITECT, WHETHER THE OBJECT FOR WHICH THEY ARE MADE IS EXECUTED OR NOT. IT SHALL BE UNLAWFUL FOR ANY PERSON TO DUPLICATE OR TO MAKE COPIES OF SAID DOCUMENTS FOR USE IN THE REPETITION OF AND FOR OTHER PROJECTS OR BUILDINGS, WHETHER EXECUTED PARTLY OR IN WHOLE, WITHOUT THE WRITTEN CONSENT OF ARCHITECT OR AUTHOR OF SAID DOCUMENTS.

PROJECT TITLE:	<b>AS-BUILT PLAN OF LAWRENCE BUNZEL BUILDING</b>
OWNER:	UNIVERSITY OF SAN CARLOS
LOCATION:	TALAMBAN, CEBU CITY, PHILIPPINES

SHEET CONTENTS
FOURTH FLOOR PLAN
ENCODED BY: MARK V. MEDRANO
REVISED BY:

REVISIONS
1
2
3

APPROVED:
<b>FR. DIONISIO M. MIRANDA, SVD</b> PRESIDENT
ADDRESS:

CONTRACT DRAWING NO.
<b>A-006</b> <b>A-000</b>
DATE: